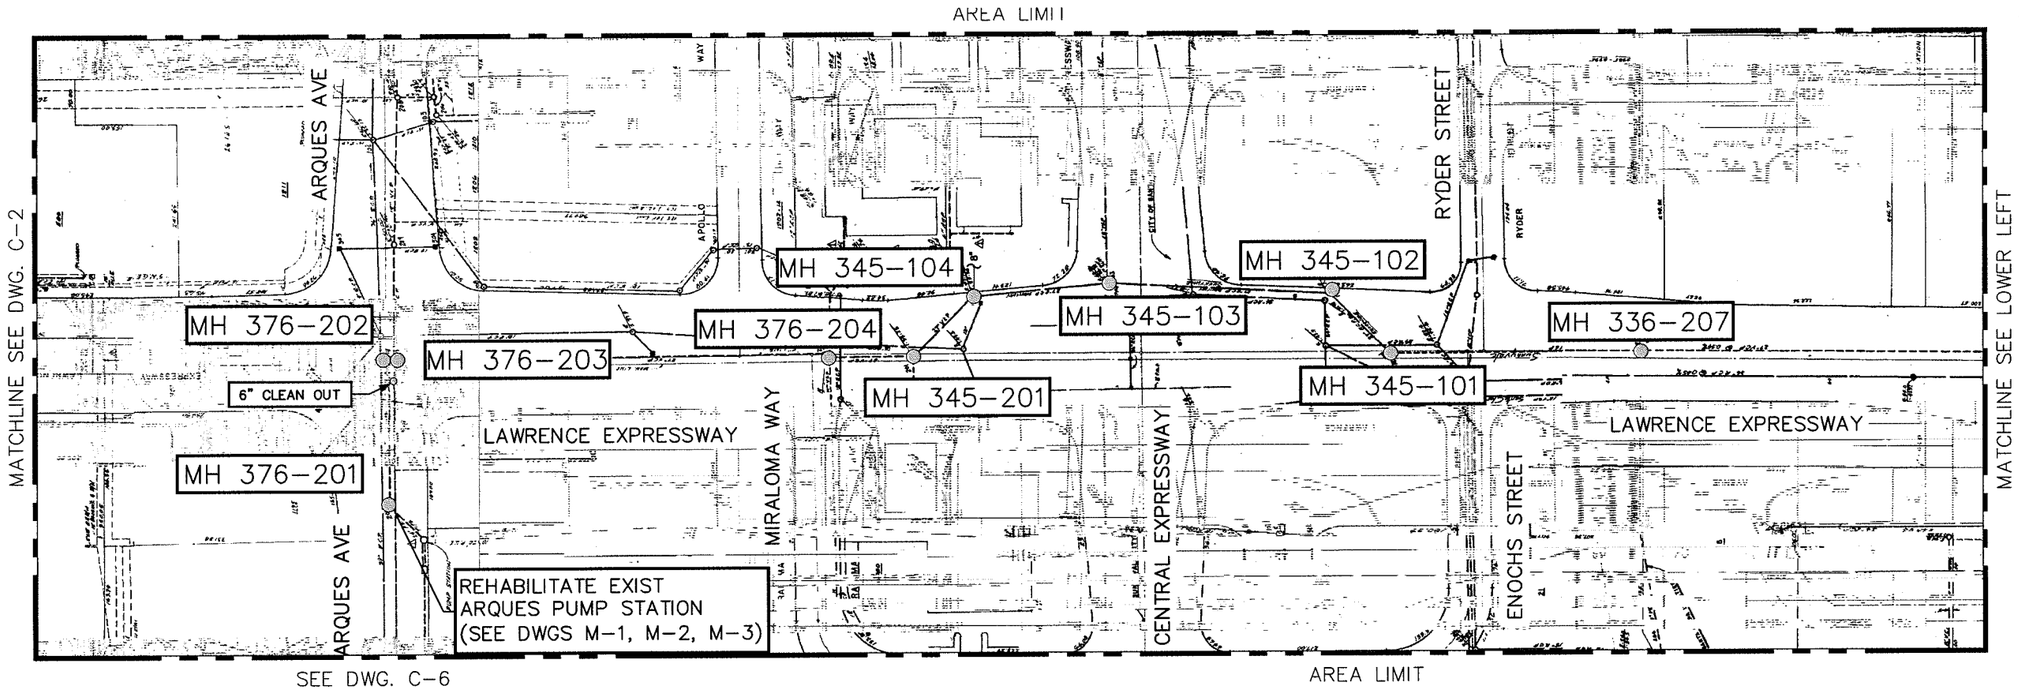

MANHOLE LOCATION PLAN

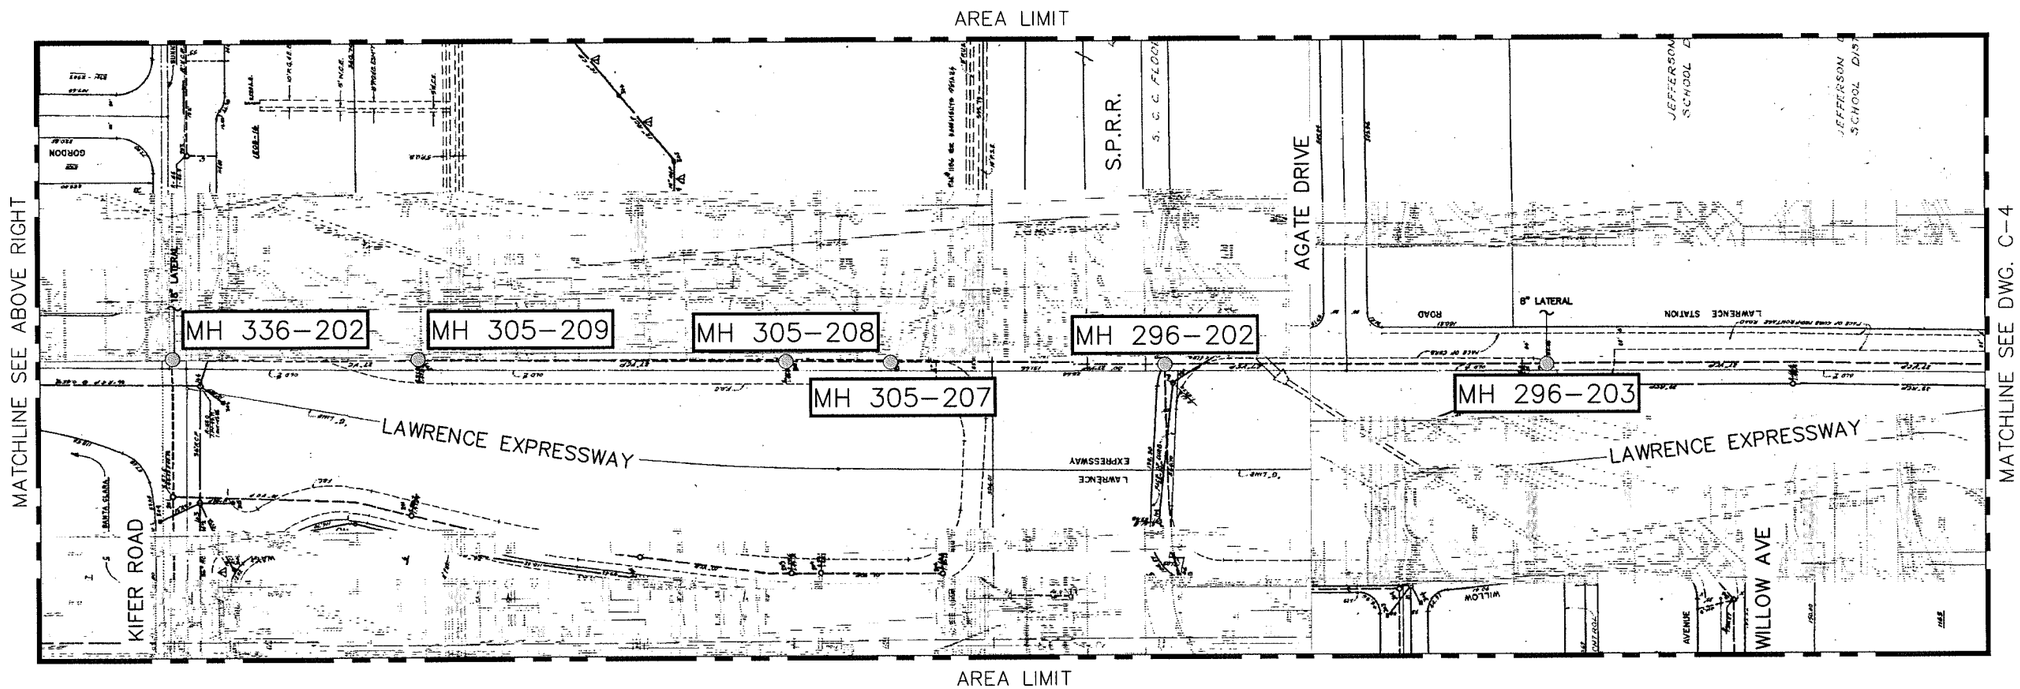

MANHOLE LOCATION PLAN

NOTES:

1. SEE DRAWINGS C-12, C-13, C-14 AND C-19 (MH376-210A & MH376-201) FOR REHABILITATION DETAILS.

100' 0' 100' 200'
SCALE: 1" = 100'

G	RECORD DRAWINGS	3/5/07

LEE&RO, Inc.
Walnut Creek, California

Scale	AS NOTED
Designed By:	TJB
Drawn By:	KSC
Checked By:	BOG
Consultant's	

REHABILITATION OF MANHOLES
LAWRENCE TRUNK SEWER

MANHOLE LOCATION MAP – (3)

CITY OF SUNNYVALE CALIFORNIA

City of Sunnyvale
Santa Clara County
California

Department of Public Works
456 West Olive Avenue
P.O. Box 3707
Sunnyvale 94088-3707

City of Sunnyvale
Project No.
UY-02/05-03

Drawing No.
C-3