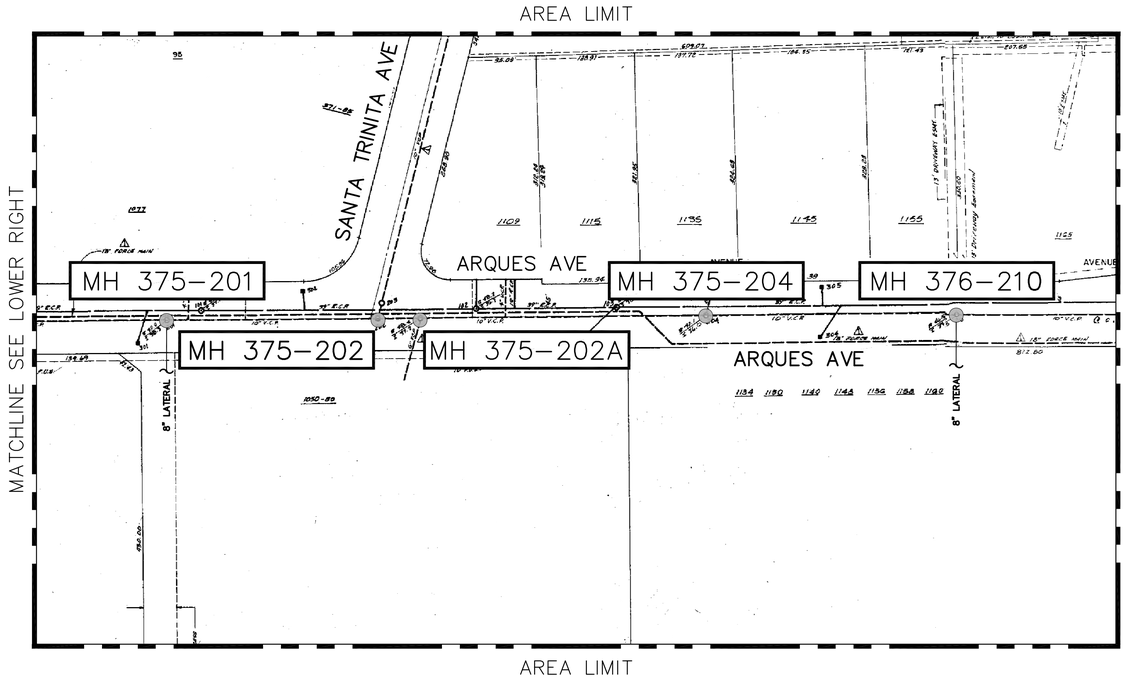

MANHOLE LOCATION PLAN

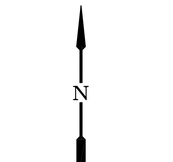

SCALE: 1"=100'

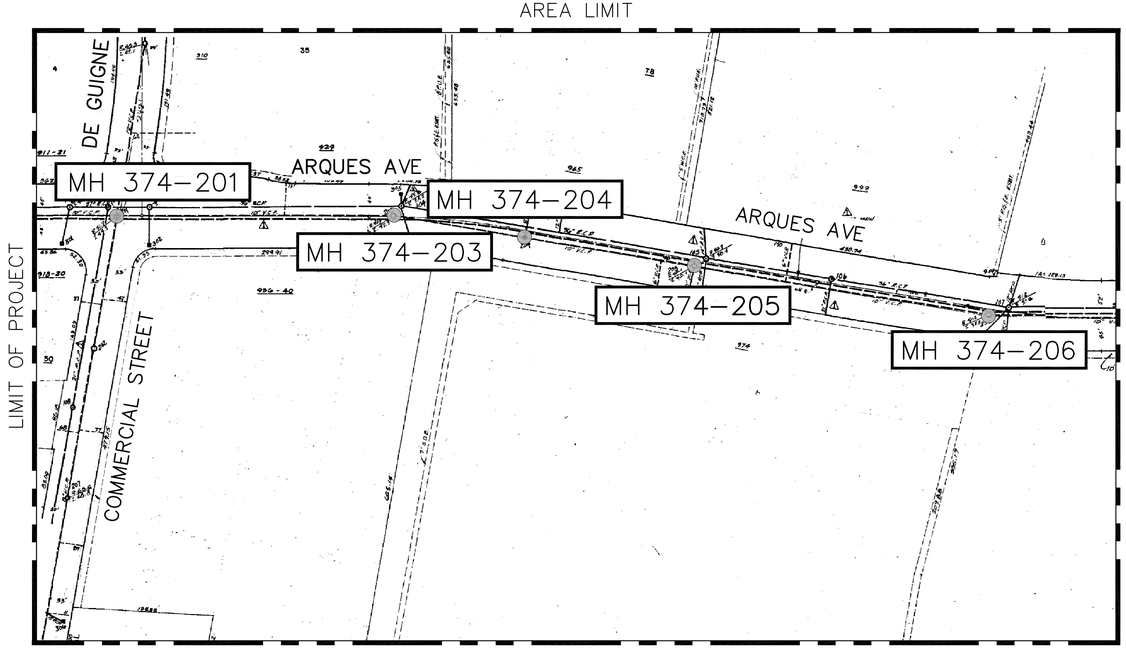

MANHOLE LOCATION PLAN

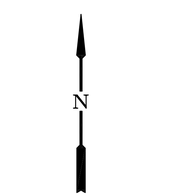

SCALE: 1"=100'

NOTES:

1. SEE DRAWINGS C-18 AND C-19 FOR REHABILITATION DETAILS.

100' 0' 100' 200'

SCALE: 1" = 100'

Rev.	Description	Date
G	RECORD DRAWINGS	3/5/07

LEE&RO. Inc.
Walnut Creek, California

Scale	AS NOTED
Designed By:	TJB
Drawn By:	KSC
Checked By:	BOG
Consultant's Job No.	610-01

REHABILITATION OF MANHOLES
LAWRENCE TRUNK SEWER

MANHOLE LOCATION MAP – (6)

CITY OF SUNNYVALE CALIFORNIA

City of Sunnyvale
Santa Clara County
California

Department of Public Works
456 West Olive Avenue
P.O. Box 3707
Sunnyvale 94088-3707

City of Sunnyvale
Project No.
UY-02/05-03

Drawing No.
C-6

Sheet 8 of 25