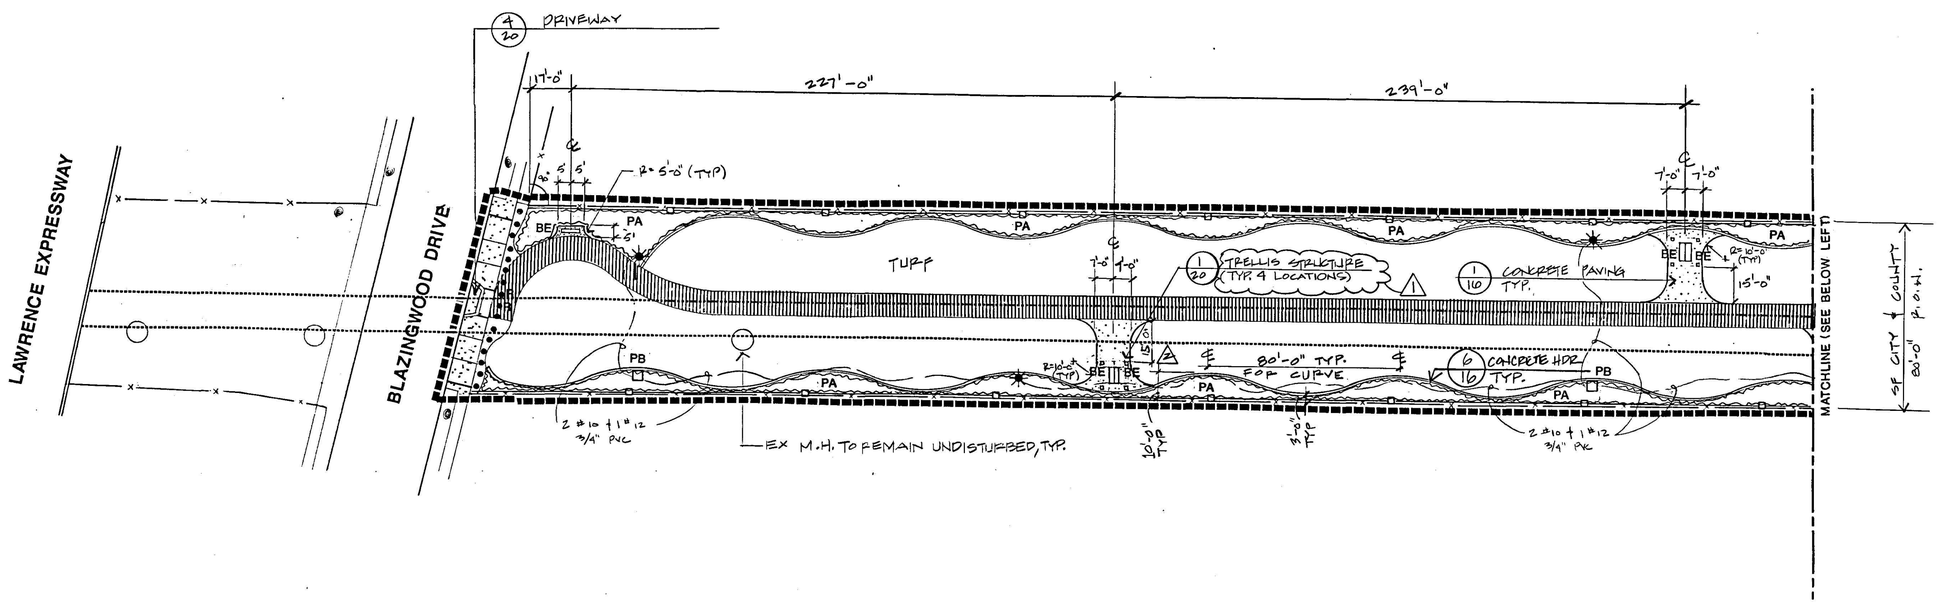

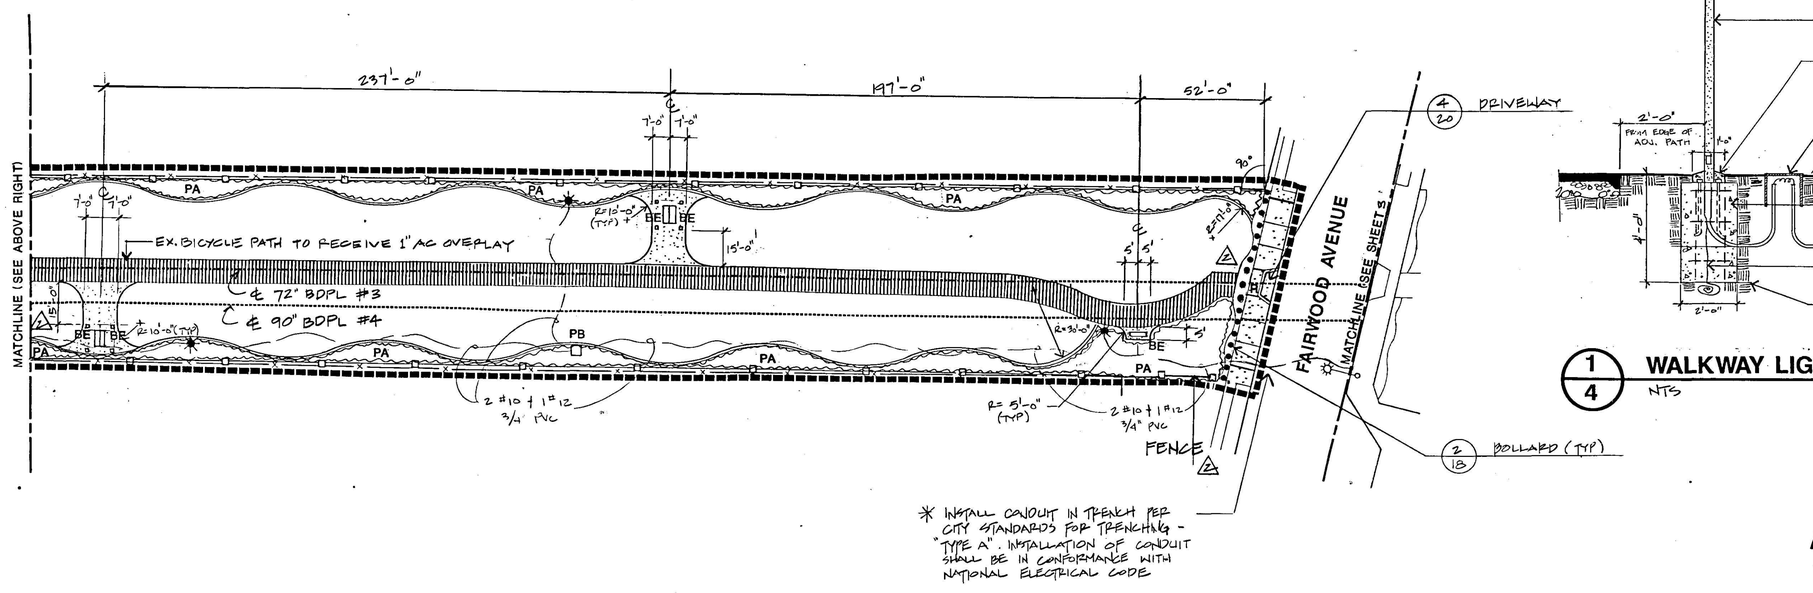

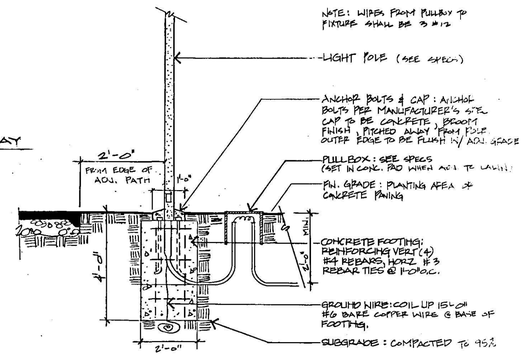

1/4 **WALKWAY LIGHT & PULL BOX** (ADD ALTERNATE)
NTS

(REFER TO SHEET 2 FOR CONSTRUCTION NOTES & LEGEND)

"RECORD DRAWINGS" 0 15 30 60 FEET NORTH

PR-93-5

PROJ. 4

Callander Associates
Landscape Architecture
Park and Recreation Design
Waterfront Planning
Land Planning

311 Seventh Avenue
San Mateo, CA 94401
(415) 375-1313
Fax (415) 344-3290
Ca. Lic. #1308

299 Cannery Row
Monterey, CA 93940
(408) 646-1383
Fax (408) 373-8653
Ca. Lic. #3099

Revisions
1 7/14/94 AA ADD NOTE
2 RECORD DRAWINGS 11-5-96

REGISTERED LANDSCAPE ARCHITECT FELIX CALLANDER No. 1308 Expires 7/31/96 STATE OF CALIFORNIA

LAYOUT AND ELECTRICAL PLAN
FAIRWOOD SCHOOL AND PARK
1110 FAIRWOOD AVENUE SUNNYVALE, CALIFORNIA

BUILT RECEIVED DATE APR 23

Date	4-13-94
Scale	1"=30'-0"
Drawn	JJ
Checked	BH
Project No.	91.067

Sheet No. 4 of 23