NOTES

1. **TREE PROTECTION:** THE AREA BELOW THE DRIPLINE OF ALL EXISTING TREES TO REMAIN SHALL BE PROTECTED FROM DAMAGE WITH FENCING (TEMPORARY CHAIN LINK OR EQUAL). NO STOCKPILING OF MATERIALS SHALL BE ALLOWED BELOW DRIP LINE OF TREES.
2. **MULCH AREAS:** FINISH GRADE OF MULCH AREA SHALL BE 2" BELOW ADJACENT FINISH GRADES.
3. **SITE PERIMETER SECURITY FENCING:** CONTRACTOR SHALL SECURE PROJECT SITE WITH TEMPORARY SIX FOOT (6') CHAINLINK FENCING DURING CONSTRUCTION AND LANDSCAPE MAINTENANCE PERIOD, AND SHALL PROVIDE NECESSARY ACCESSES TO SITE WHICH SHALL BE SECURED AT THE END OF EACH WORK DAY.
4. **EXISTING IRRIGATION SYSTEM COMPONENTS (TO BE REMOVED):** CONTRACTOR SHALL SALVAGE ALL VALVES IN REUSABLE CONDITION AND DELIVER TO THE SUNNYVALE SCHOOL DISTRICT CORPORATION YARD, 825 W. IOWA, SUNNYVALE, CA ; CONTACT RUDY NASOL, (408) 736-4981, EXT. 247. EXISTING IRRIGATION HEADS SHALL BE DEMOLISHED AND EXISTING PIPING SHALL BE DEMOLISHED AS NEEDED FOR REGRADING. PIPING MAY REMAIN WITH 12" MIN. COVER WHERE FINISHED GRADE ALLOWS.
5. **SAN FRANCISCO WATER DEPARTMENT PIPELINES:** MAINTAIN MINIMUM 3 FEET OF COVER OVER THE TOP OF ALL SAN FRANCISCO WATER PIPELINES. ALL NEW PIPES CROSSING THE SAN FRANCISCO WATER PIPELINES MUST BE PERPENDICULAR AND A MINIMUM OF ONE FOOT CLEAR ABOVE SAN FRANCISCO WATER PIPELINES. NO HEAVY EQUIPMENT SHALL BE USED OVER THE SAN FRANCISCO WATER PIPELINES AT ANY TIME.

LEGEND

- LIMIT OF WORK
- EXISTING FENCE
- EXISTING TREE TO REMAIN
- SURFACE SLOPE DIRECTION
- DRAINAGE SWALE, MIN 1% SLOPE
- CATCH BASIN, PER SPECS (3/15)
- AREA DRAIN, PER SPECS (1/15)
- RIM ELEVATION
- INV INVERT ELEVATION
- HP HIGH POINT
- DEPRESSION CONTOUR (PROPOSED)
- PROPOSED CONTOUR (ONE-FOOT CONTOUR)
- EXISTING BACKSTOP TO BE REMOVED & REFURBISHED, PER SPECS
- TRENCH DRAIN (4/15)
- DROP INLET (6/15)
- T.R. TO REMAIN
- T.B.R. TO BE REMOVED
- DRAINLINE, SDR 35 PVC, SIZE PER PLAN
- DRAINLINE, CIP, 3" DIAMETER
- SANITARY SEWER LINE, 4"ø, ABS, SDR-35, (ASTM D 2751) W/JOINT SOLVENT ABS CEMENT (ASTM D 2235) (1)
- FS FINISHED SURFACE
- (E) EXISTING
- B.A.D.P.L. BAY DISTRICT PIPELINE

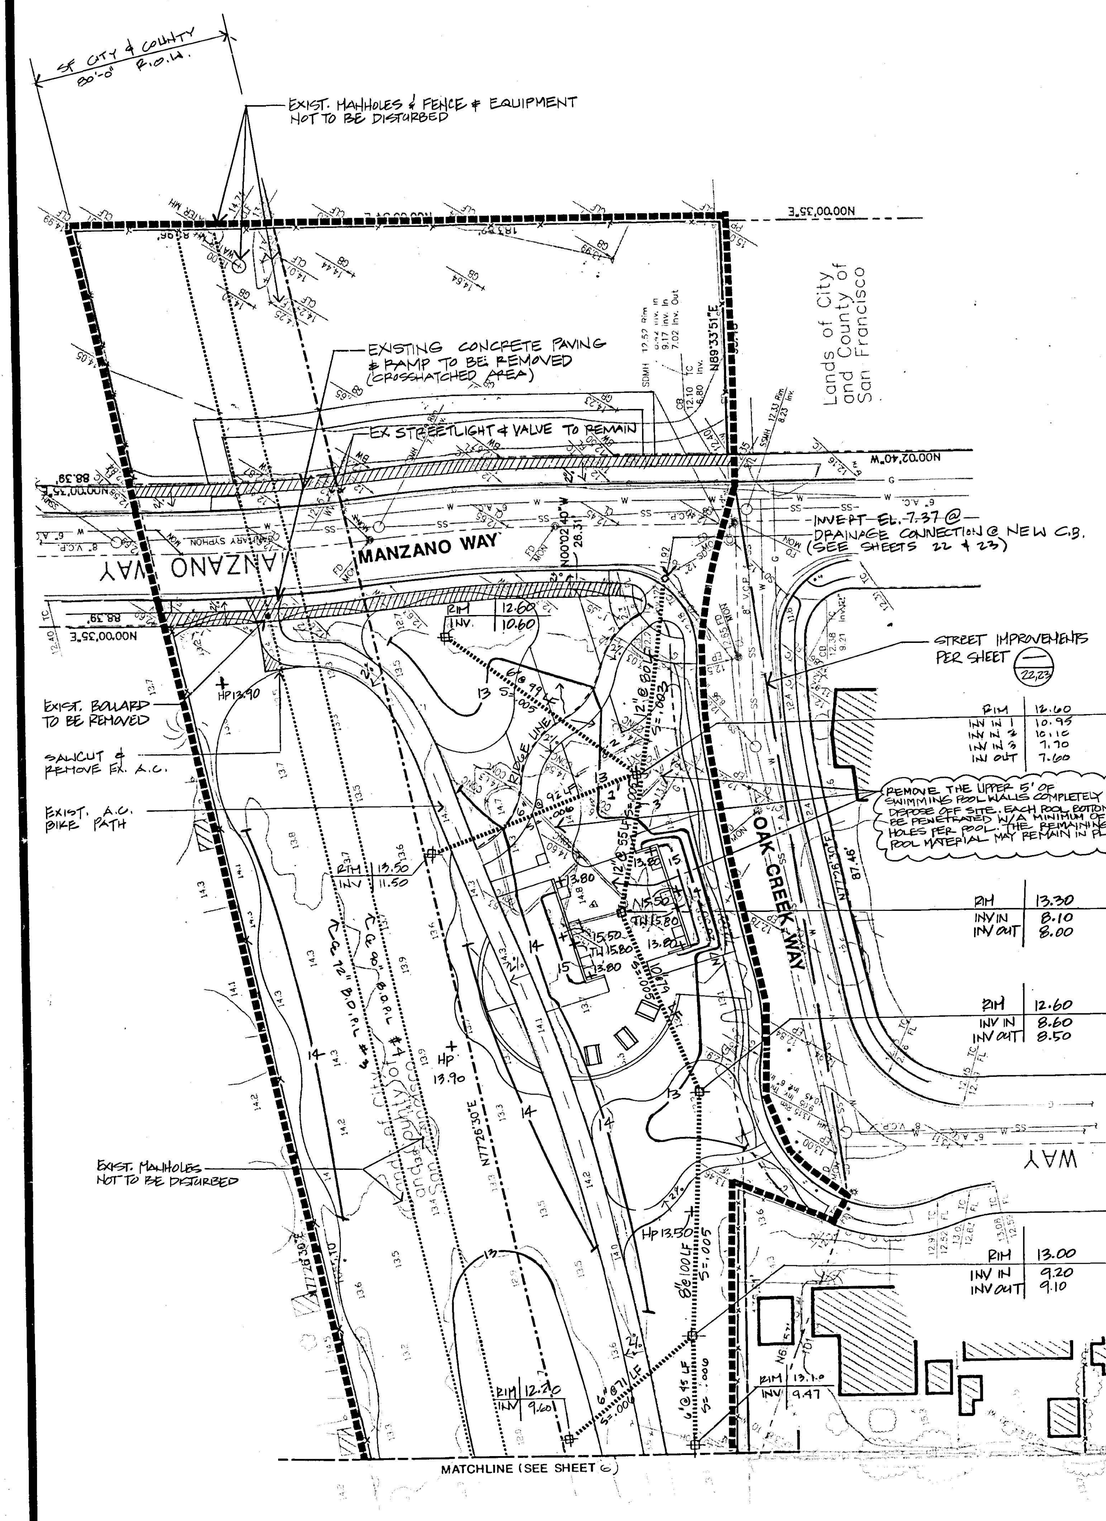

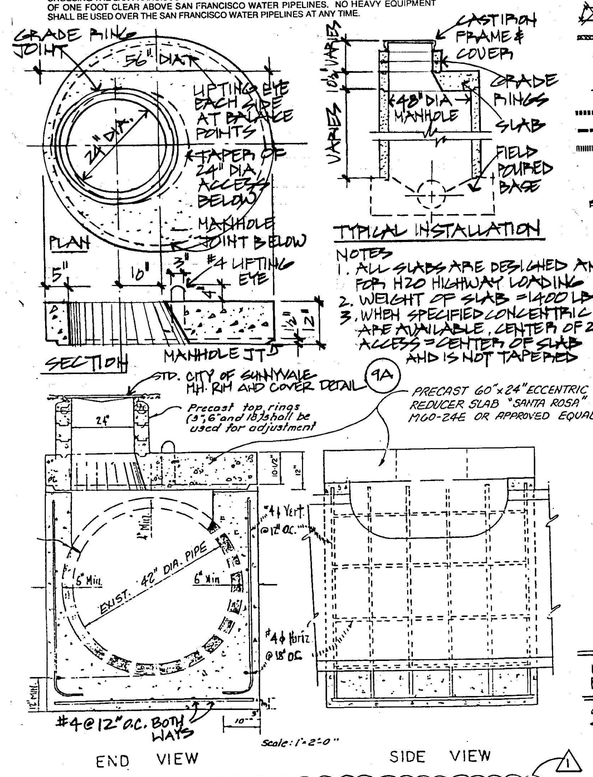

1/5 **MANHOLE (CITY STD. DETAIL 2A-MODIFIED)**
SCALE: AS SHOWN

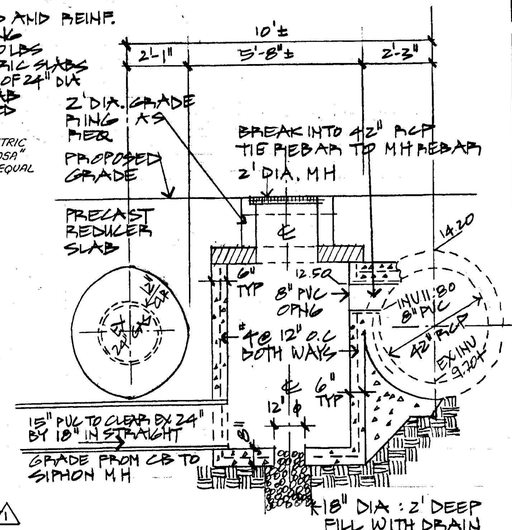

2/5 **SIPHON MANHOLE**
NOT TO SCALE

(N00°02'40"W)

OAK CREEK WAY

(N00°02'40"W)

AS-BUILT RECEIVED
DATE
5 OF 23 SHEETS
"RECORD DRAWING"

0 15 30 60 FEET
NORTH

PR-93-5 PL006-5

Callander Associates
Landscape Architecture
Park and Recreation Design
Waterfront Planning
Land Planning

311 Seventh Avenue
San Mateo, CA 94401
(415) 375-1313
Fax (415) 344-3290

299 Cannery Row
Monterey, CA 93940
(408) 646-1383
Fax (408) 373-8653
Ca. Lic. # 3199

Revisions	
1	7/14/94 AP
	DELETE NOTE
	CHANGE NOTE
2	RECORD
	DWGS 3/23/96

REGISTERED LANDSCAPE ARCHITECT
KEVIN CALLANDER
No. 1308
Expires 2/14/98
STATE OF CALIFORNIA

GRADING AND DEMOLITION PLAN
FAIRWOOD SCHOOL AND PARK
1110 FAIRWOOD AVENUE SUNNYVALE, CALIFORNIA

Date	~~4-13-94~~
Scale	1"=30'-0"
Drawn	JJ
Checked	BH
Project No.	91.067
Sheet No.	5 of 23