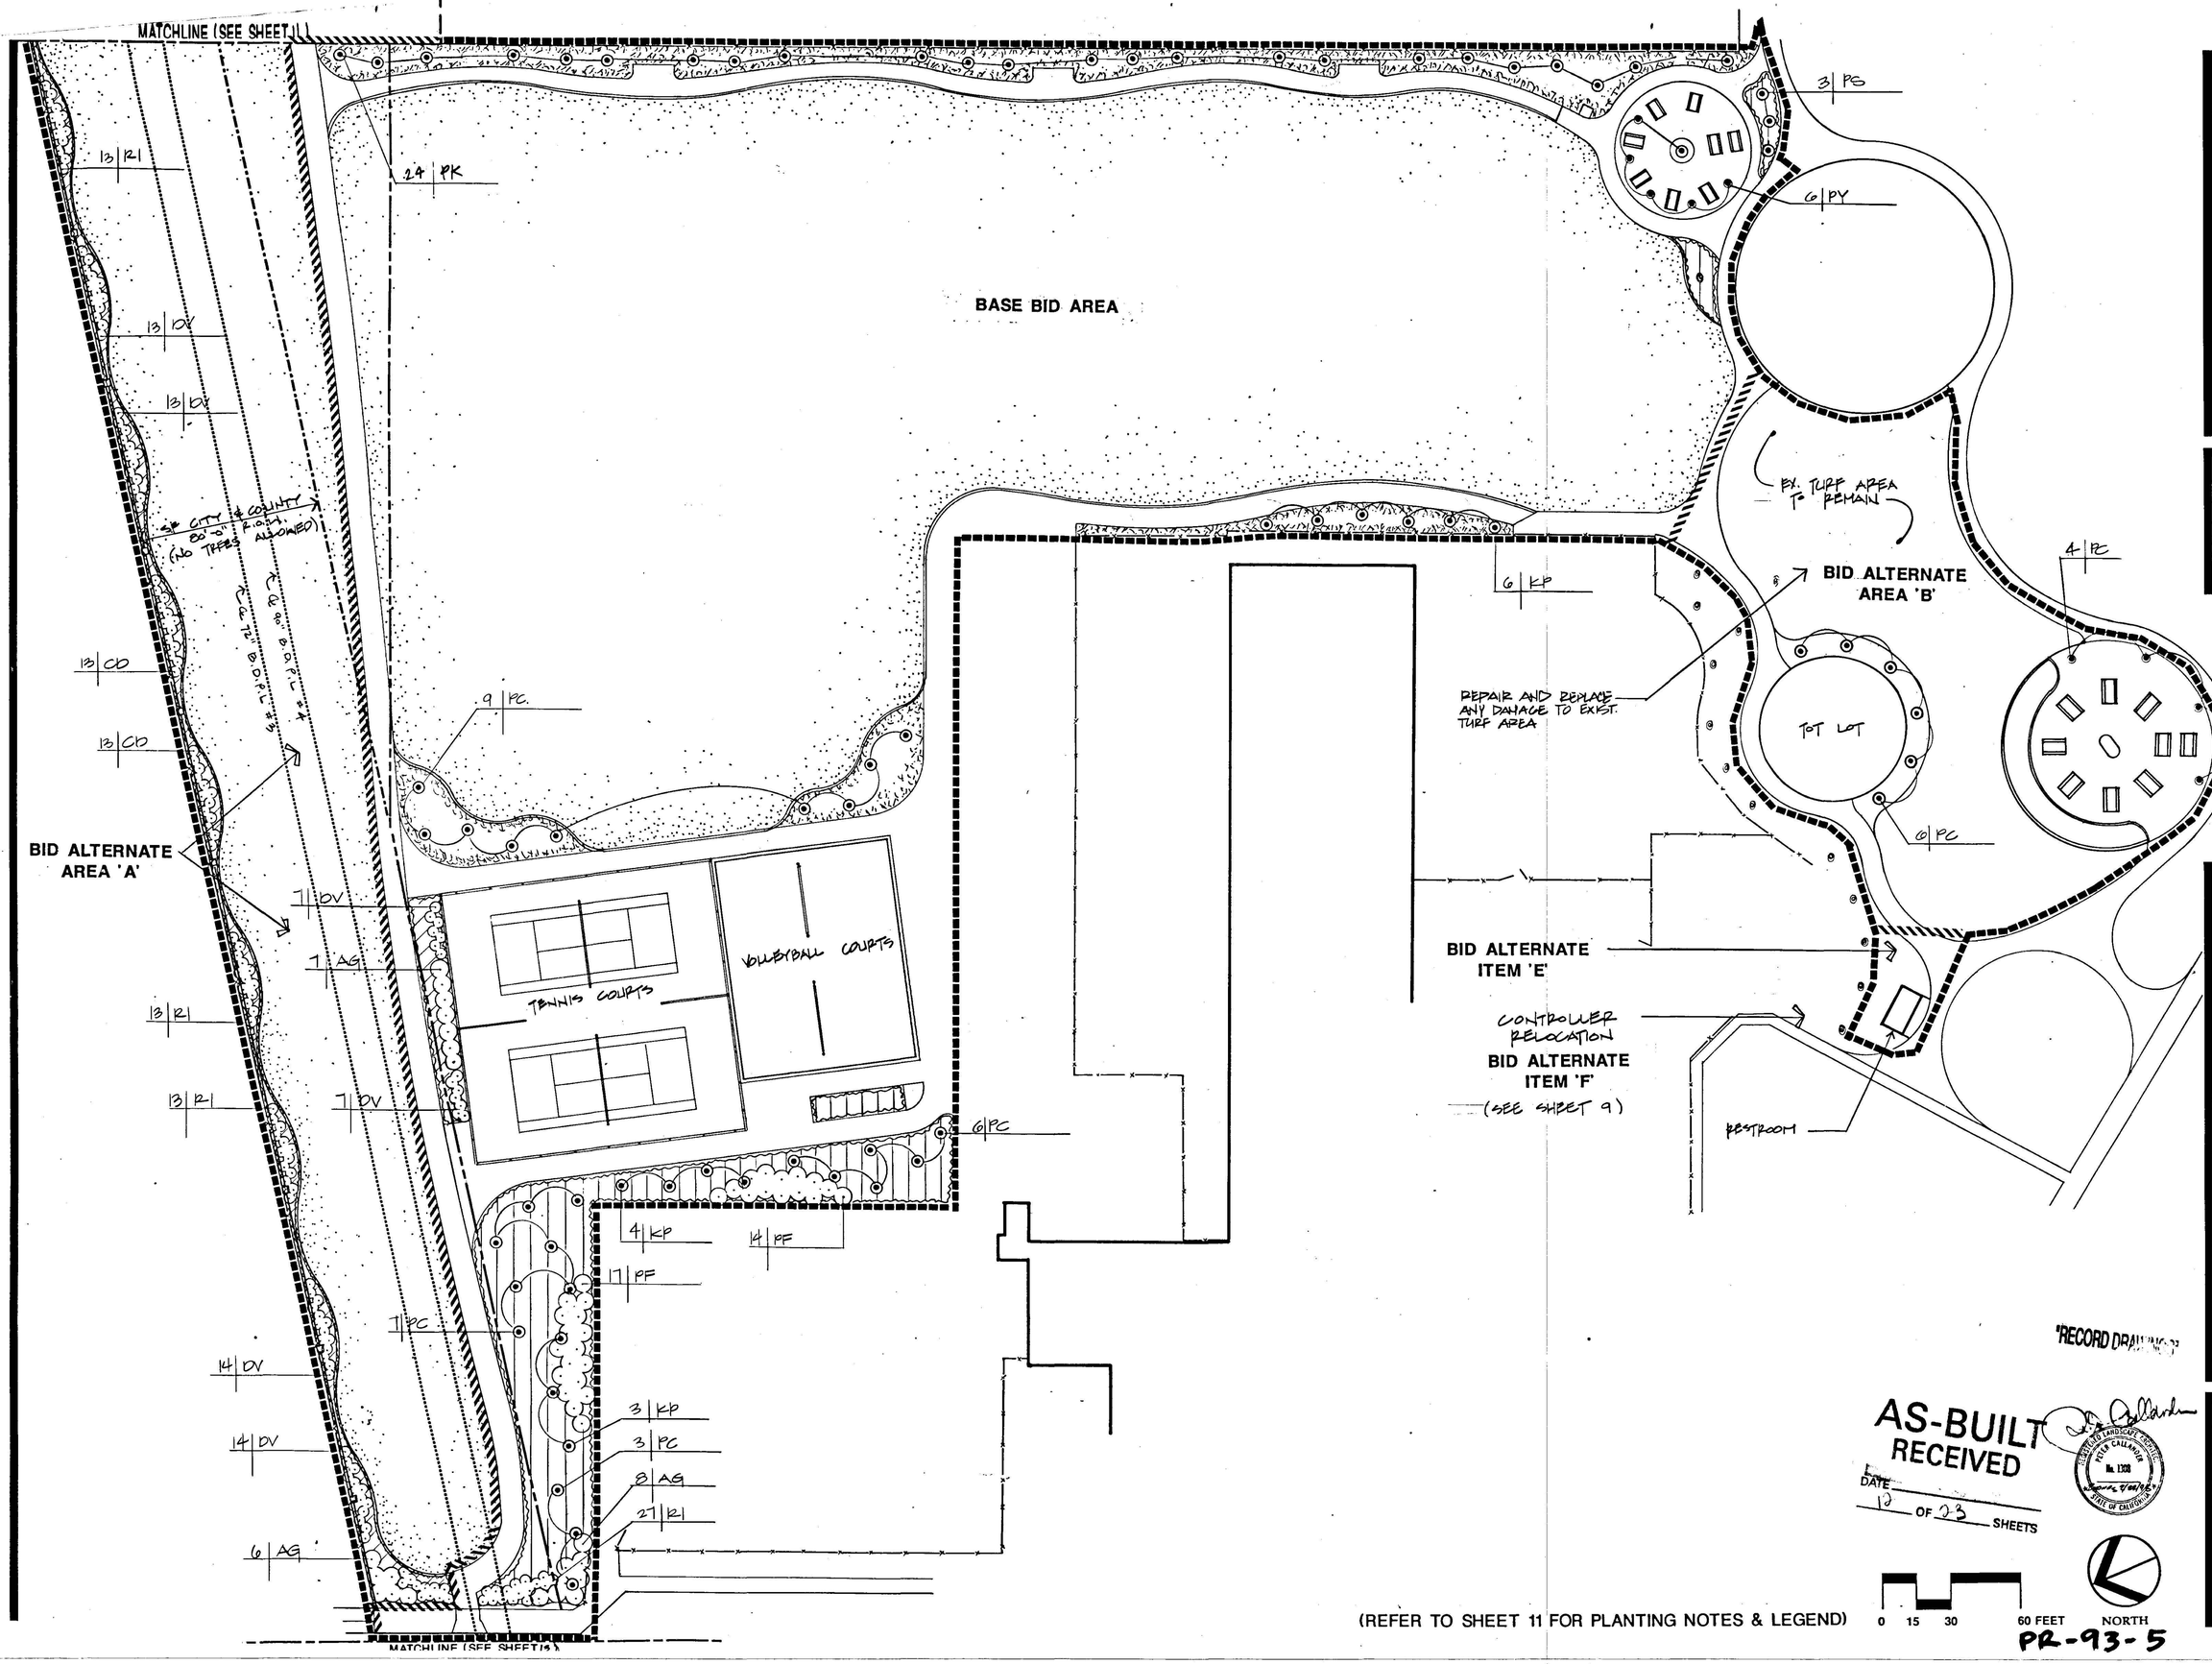

(REFER TO SHEET 11 FOR PLANTING NOTES & LEGEND)

0 15 30 60 FEET NORTH

Callander Associates
Landscape Architecture
Park and Recreation Design
Waterfront Planning
Land Planning

311 Seventh Avenue
San Mateo, CA 94401
(415) 375-1313
Fax (415) 344-3290
Ca. Lic. #1308

299 Cannery Row
Monterey, CA 93940
(408) 646-1383
Fax (408) 373-8653
Ca. Lic. #3099

Revisions
RECORD DRAWING

PLANTING PLAN
FAIRWOOD SCHOOL AND PARK
1110 FAIRWOOD AVENUE SUNNYVALE, CALIFORNIA

"RECORD DRAWING"

AS-BUILT RECEIVED
DATE 12 OF 23 SHEETS

Date	4-13-94
Scale	1"=30'-0"
Drawn	JJ/ML
Checked	BH
Project No.	91.067
Sheet No.	12 of 23

PR-93-5