


**1/16 CONCRETE PAVING**

NTS

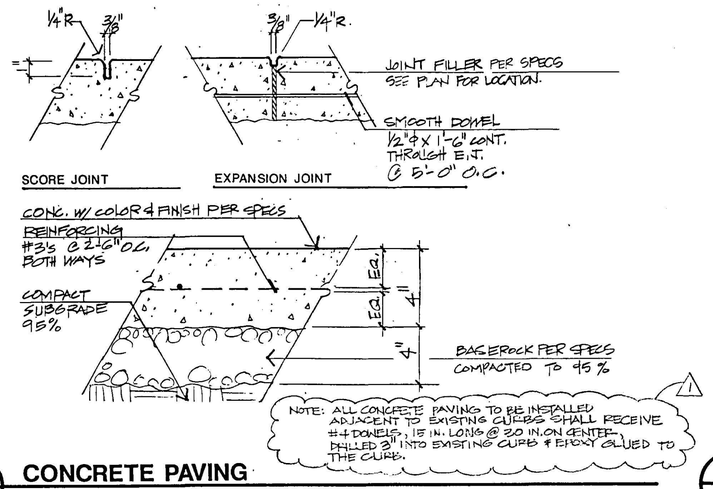


SECTION

**2/16 A/C PAVING**

1½" = 1'-0"

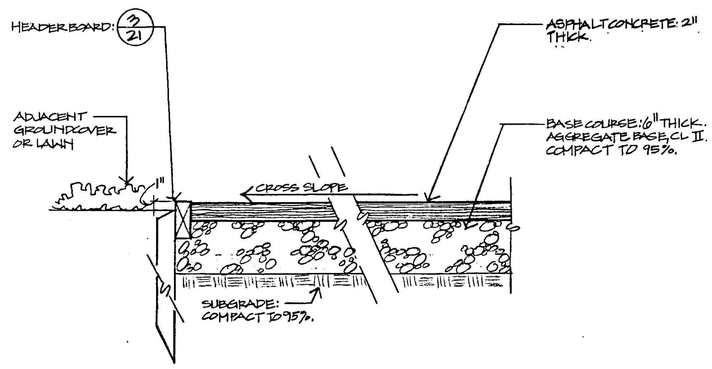


SECTION

**3/16 DECOMPOSED GRANITE PAVING**

1½" = 1'-0"

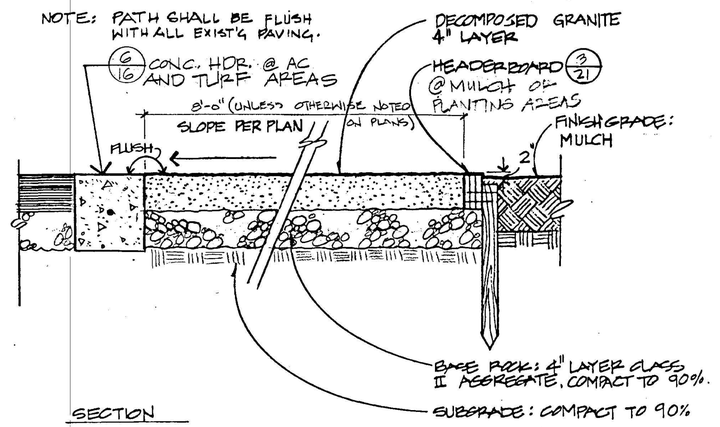


**4/16 RESILIENT SURFACING (BID ALTERNATE 'B')**

NTS




**5/16 TREE WELL**

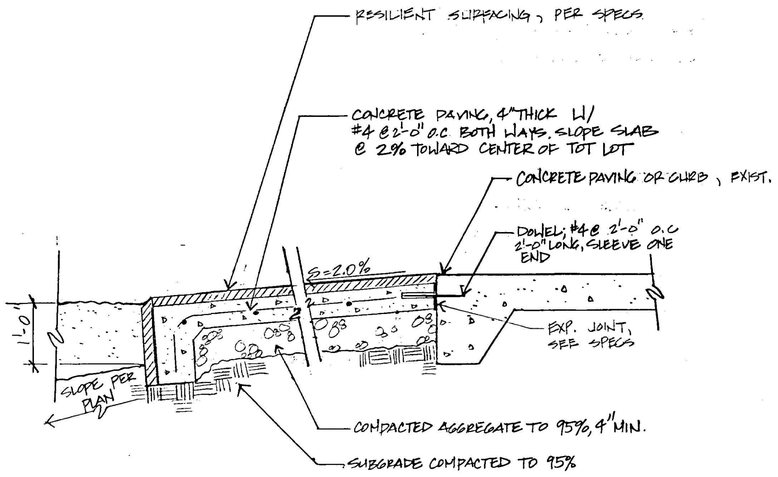1½" = 1'-0"




SECTION

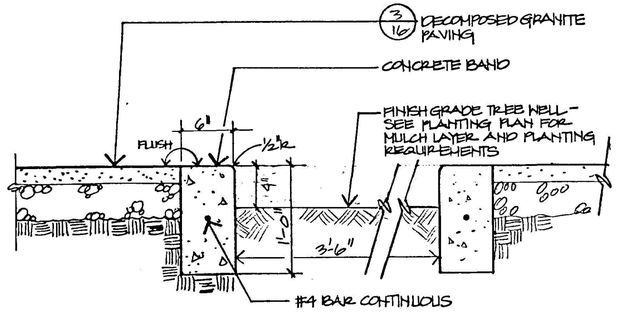**6/16 CONCRETE HEADER**

1½" = 1'-0"

AS-BUILT
RECEIVED
"RECORD DRAWINGS"
DATE
16 OF 23 SHEETS

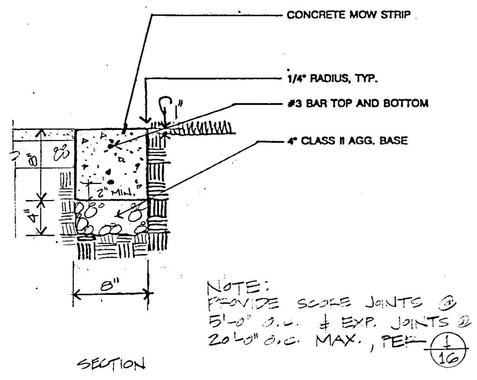PR-93-5


Callander Associates
Landscape Architecture
Park and Recreation Design
Waterfront Planning
Land Planning

311 Seventh Avenue
San Mateo, CA 94401
(415) 375-1313
Fax (415) 344-2290
Ca. Lic. #1308

299 Cannery Row
Monterey, CA 93940
(408) 646-1383
Fax (408) 373-8653
Ca. Lic. #3099


| Revisions |
|---|
| 1 7/14/94 AA |
| ADD NOTE TO DETAIL #1. |
| RECORD |
| DRAWING |

REGISTERED LANDSCAPE ARCHITECT
PETER CALLANDER
No. 1308
STATE OF CALIFORNIA

CONSTRUCITON DETAILS

FAIRWOOD SCHOOL AND PARK
1110 FAIRWOOD AVENUE SUNNYVALE, CALIFORNIA

| | |
|---|---|
| Date | ~~4-13-94~~ |
| Scale | AS SHOWN |
| Drawn | JJ |
| Checked | BH |
| Project No. | 91.067 |
| Sheet No. | 16 |
| of | 23 |

PR008.16