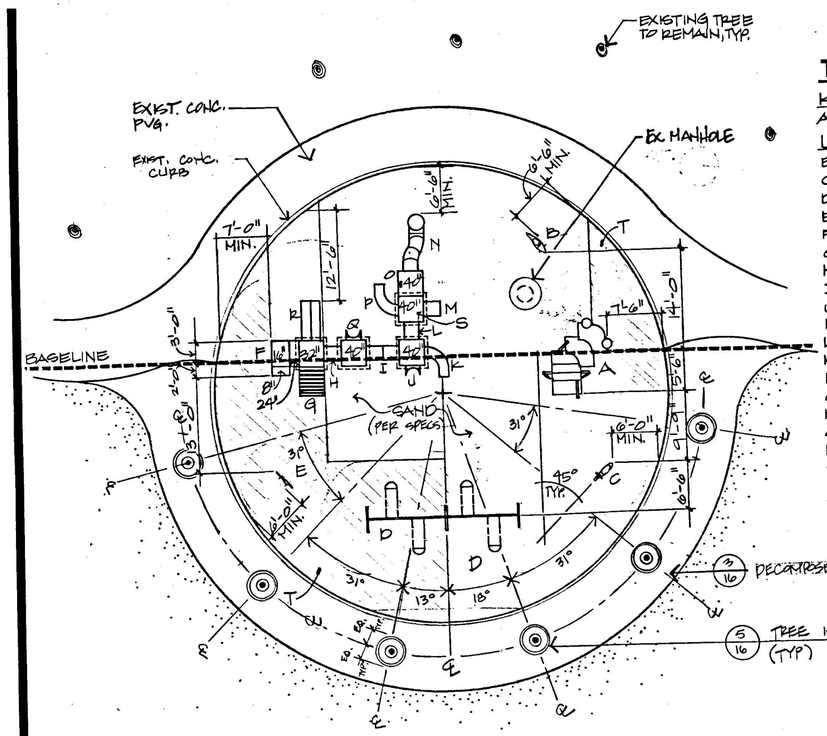

TOT LOT EQUIPMENT

KOMPAN
A SANDWORKS

LANDSCAPE STRUCTURES
B DOLPHIN SPRING RIDER
C SEA HORSE SPRING RIDER
D 2" ARCH TOT SWING
E MOTORCYCLE TUFFRIDER
F TRANSFER POINT
G COZY CLIMBER
H 28" CRAWL TUNNEL
I 56" CRAWL TUNNEL
J LOOP LADDER
K 40" CURVED POLY SLIDE
L 28" CRAWL TUNNEL
M JAIL PANEL
N EL SLIDE
O DRIVER PANEL
P 40" CURVED POLY SLIDE
Q LOOP LADDER
R 32" DOUBLE POLY SLIDE
S TUNNEL PANEL LOCATED BELOW 40" DECK
T RESILIENT SURFACING, SEE 4/16

1/19 **TOT LOT PLAY AREA-PLAN** (BID ALTERNATE 'B')
SCALE: 1"=10'-0"

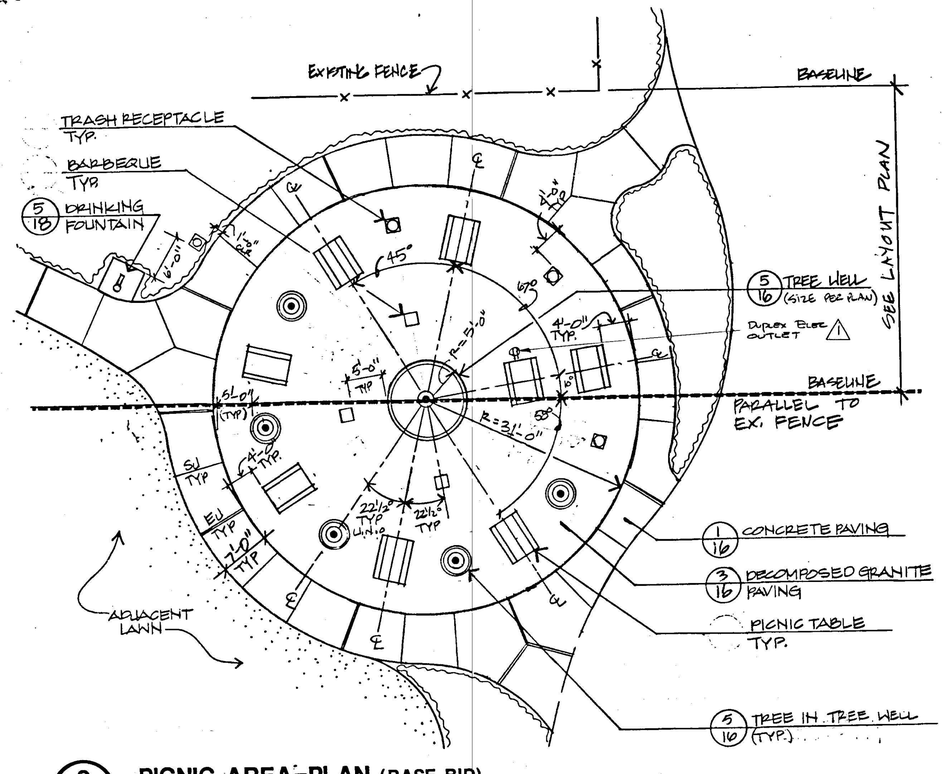

EJ=EXPANSION JOINT
SJ=SCORE JOINT

2/19 **PICNIC AREA-PLAN** (BASE BID)
SCALE: 1"=10'-0"

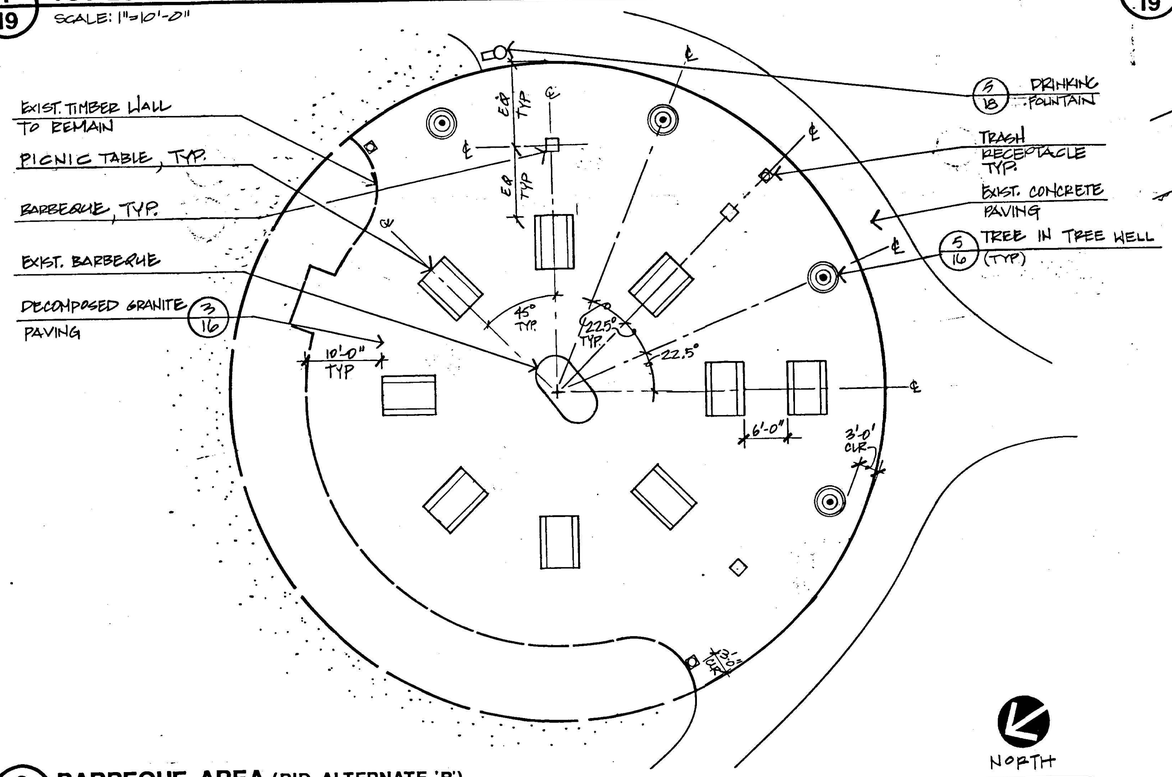

3/19 **BARBEQUE AREA** (BID ALTERNATE 'B')
SCALE: 1"=10'-0"

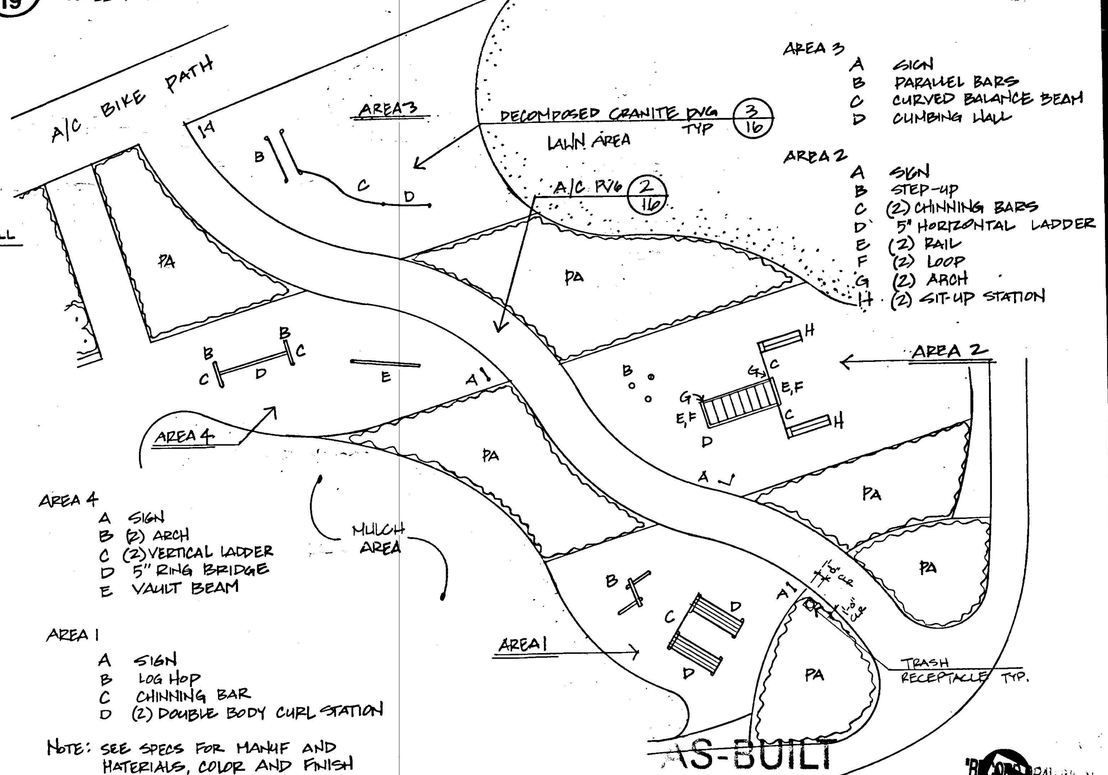

AREA 3
A SIGN
B PARALLEL BARS
C CURVED BALANCE BEAM
D CLIMBING WALL

AREA 2
A SIGN
B STEP-UP
C (2) CHINNING BARS
D 5" HORIZONTAL LADDER
E (2) RAIL
F (2) LOOP
G (2) ARCH
H (2) SIT-UP STATION

AREA 4
A SIGN
B (2) ARCH
C (2) VERTICAL LADDER
D 5" RING BRIDGE
E VAULT BEAM

AREA 1
A SIGN
B LOG HOP
C CHINNING BAR
D (2) DOUBLE BODY CURL STATION

NOTE: SEE SPECS FOR MANUF AND MATERIALS, COLOR AND FINISH

AS-BUILT RECEIVED

4/19 **FITNESS CLUSTER--PLAN** (BID ALTERNATE 'A')
SCALE: 1"=10'-0"

DATE 19 OF 23 SHEETS

PR-93-5

Callander Associates
Landscape Architecture
Park and Recreation Design
Waterfront Planning
Land Planning

311 Seventh Avenue
San Mateo, CA 94401
(415) 375-1313
Fax (415) 344-3290
Ca. Lic. #1308

299 Cannery Row
Monterey, CA 93940
(408) 646-1383
Fax (408) 373-8653
Ca. Lic. #3099

Revisions
1 RECORD DRAWINGS 1-15-96

REGISTERED LANDSCAPE ARCHITECT PETER CALLANDER No. 1308 STATE OF CALIFORNIA

CONSTRUCTION DETAILS
FAIRWOOD SCHOOL AND PARK
1110 FAIRWOOD AVENUE SUNNYVALE, CALIFORNIA

Date	4-13-94
Scale	AS SHOWN
Drawn	AB/ MD
Checked	BH
Project No.	91.067
Sheet No.	19 of 23

PR008.19/1