PLANS FOR THE IMPROVEMENT OF
OAK CREEK WAY

GENERAL NOTES:

1. ALL MATERIAL AND WORKMANSHIP SHALL FULLY CONFORM WITH THE LATEST SPECIFICATIONS, STANDARDS AND ORDINANCES OF THE CITY OF SUNNYVALE. THE CITY OF SUNNYVALE'S STANDARD SPECIFICATIONS AND DETAILS ARE AVAILABLE AT THE CITY HALL, SUNNYVALE.
2. ALL ELEVATIONS SHOWN ARE ON CITY OF SUNNYVALE DATUM.
3. ALL STANDARD STREET MONUMENTS LOT CORNER PIPES AND OTHER PERMANENT MONUMENTS DISTURBED DURING THE PROCESS OF CONSTRUCTION SHALL BE REPLACED BEFORE ACCEPTANCE OF THE IMPROVEMENTS BY THE CITY OF SUNNYVALE. CORNER MARKERS AND MONUMENTS FOUND, DISTURBED, AND REPLACED, SHALL BE BROUGHT TO THE ATTENTION OF THE CITY ENGINEERING DEPARTMENT AND FILED AS REQUIRED BY THE COUNTY. CORNER PIPES AND MONUMENTS TO BE SET PURSUANT TO THE FINAL MAP SHALL BE SET PRIOR TO ACCEPTANCE OF IMPROVEMENTS.
4. MANHOLE FRAMES AND COVERS SHALL BE BROUGHT TO FINISH GRADE BEFORE FINAL PAVING.
5. IT IS THE CONTRACTOR'S RESPONSIBILITY TO VERIFY THE LOCATION OF ALL EXISTING UTILITIES WITH THE APPROPRIATE AGENCIES. CALL U.S.A.
6. CITY CONST. INSPECTOR SHALL HAVE 24-HOUR NOTICE FOR INSPECTION.
7. APPROVAL OF THESE PLANS DOES NOT RELIEVE THE DEVELOPER OF THE RESPONSIBILITY FOR THE CORRECTION OF MISTAKES, ERRORS OR OMISSIONS.
8. IF, DURING THE COURSE OF CONSTRUCTION OF THE IMPROVEMENTS, THE PUBLIC INTEREST REQUIRES MODIFICATION OF OR A DEPARTURE FROM THE CITY'S SPECIFICATIONS, DETAILS OR THESE IMPROVEMENT PLANS, THE CITY ENGINEER (DIRECTOR OF PUBLIC WORKS) SHALL REQUIRE IN WRITING, SUCH MODIFICATION OR DEPARTURE AND TO SPECIFY THE MANNER IN WHICH SAME IS TO BE DONE.
9. CONTRACTOR SHALL PROVIDE THE CITY WITH AN "AS-BUILT" PLAN, SHOWING ALL WATER SERVICE LOCATIONS, METER LOCATIONS AND SANITARY SEWER LATERAL LOCATIONS.
10. ALL UTILITY SERVICE LATERALS DAMAGED DURING CONSTRUCTION SHALL BE REPLACED TO THE SATISFACTION OF THE CITY ENGINEER.
11. ALL ABUTTING PROPERTIES SHALL BE PROVIDED ACCESS AT ALL TIMES DURING CONSTRUCTION OF UTILITIES. TRENCHES SHALL BE BACKFILLED AND PAVED (TEMPORARY CUTBACK ASPHALT) PRIOR TO LEAVING THE JOB SITE EACH WORK DAY.
12. GRADE BREAKS ON CURBS AND SIDEWALKS TO BE ROUNDED OFF IN FORM WORK AND FINISHED SURFACING.
13. THE TYPES, LOCATIONS, SIZES AND/OR DEPTHS OF EXISTING UNDERGROUND UTILITIES AS SHOWN IN THE IMPROVEMENT PLANS WERE OBTAINED FROM SOURCES OF VARYING RELIABILITY. THE CONTRACTOR IS CAUTIONED THAT ONLY ACTUAL EXCAVATION WILL REVEAL THE TYPES, EXTENT, SIZES, LOCATIONS AND DEPTHS OF SUCH UNDERGROUND UTILITIES. (A REASONABLE EFFORT HAS BEEN MADE TO LOCATE AND DELINEATE ALL KNOWN UNDERGROUND UTILITIES.) HOWEVER, THE ENGINEER CAN ASSUME NO RESPONSIBILITY FOR THE COMPLETENESS OR ACCURACY OF ITS DELINEATION OF SUCH UNDERGROUND UTILITIES NOR FOR THE EXISTENCE OF OTHER BURIED OBJECTS OR UTILITIES WHICH MAY BE ENCOUNTERED BUT WHICH ARE NOT SHOWN ON THESE DRAWINGS.
14. MANHOLES SHALL BE "TYPE I" UNLESS OTHERWISE SPECIFIED.
15. DRAIN INLETS SHALL BE STANDARD 24" CURB DROP INLETS UNLESS OTHERWISE SPECIFIED.
16. ALL UTILITY STRUCTURES INCLUDING BUT NOT LIMITED TO MANHOLES, CATCH BASINS, WATER VALVES FIRE HYDRANTS, TELEPHONE AND ELECTRIC VAULTS AND PULL BOXES THAT LIE WITHIN THE PUBLIC RIGHT-OF-WAY, EASEMENTS OR AREAS EFFECTED BY THE WORK ON THIS PROJECT SHALL BE ADJUSTED TO GRADE BY THE CONTRACTOR OR THE RESPECTIVE UTILITY COMPANY FOR WHICH THE CONTRACTOR IS RESPONSIBLE TO AFFECT COORDINATION.

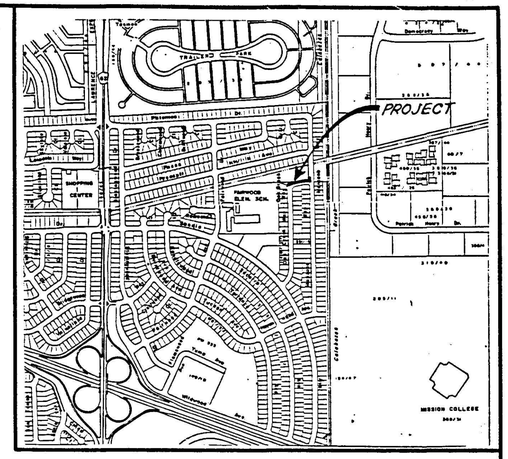

VICINITY MAP

LEGEND

EXISTING	PROPOSED	
		CURB & GUTTER
		SIDEWALK
		NEW PAVEMENT SECTION
SS	SS	SANITARY SEWER AND MANHOLE
SD	SD	STORM SEWER AND MANHOLE
SD		STORM CATCH BASIN AND LATERAL
W		WATER MAIN
		FIRE HYDRANT
W		GATE VALVE
		MONUMENT
		ELECTROLIER
S		STREET SIGN
		TRAFFIC SIGNS
		EXISTING EDGE OF PAVEMENT
		SAW-CUT PAVEMENT
		CONFORM TO EXISTING

ABBREVIATIONS

BC	BEGIN CURVE
CB	CATCH BASIN
CONC	CONCRETE
EC	END CURVE
EP	EDGE OF PAVEMENT
ER	END RETURN
EX	EXISTING
FL	FLOW LINE
GND	GROUND
INV	INVERT
JP	JOINT POLE (TELEPHONE, ELECTRIC & CABLE TV)
P	PAVEMENT
PRC	POINT OF REVERSE CURVE
PRVC	POINT OF REVERSE VERTICAL CURVE
TC	TOP OF CURB
VC	VERTICAL CURVE
VCP	VITRIFIED CLAY PIPE

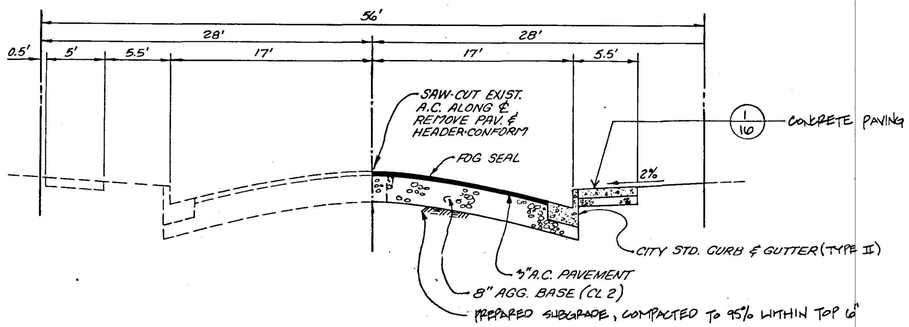

TYPICAL SECTION - OAK CREEK WAY

AS-BUILT

22 OF 23 SHEETS

APPROVALS:

DATE APPROVED _____ ASSIST. DIRECTOR OF P.W./CITY ENGINEER

DATE REVIEWED: _____ ENGINEERING

DATE REVIEWED _____ CONSTRUCTION

DATE REVIEWED: _____ PUBLIC SAFETY

DATE REVIEWED: _____ TRAFFIC

DATE REVIEWED: _____ FIELD SERVICES DIVISION

3-12-93

605 Castro Street
P.O. Box 640
Mountain View CA
94042-0640
Tel (415) 969-6900
Fax (415) 969-6472

SANDIS HUMBER JONES
CIVIL ENGINEERS SURVEYORS PLANNERS

DATE:	4-13-94
SCALE:	NONE
DRAWN BY:	J.M.S.
APPROVED BY:	G.B.C.
DRAWING NO.	291193

DATE _____, 1993

TIMOTHY D. SANDIS
R.C.E. NO. 15290, EXPIRES 3-31-92

No.	REVISION	DATE	BY
	RECORD DRAWING		

COVER SHEET
OAK CREEK WAY
SUNNYVALE (BID ALTERNATE ITEM 'G') CALIFORNIA

"RECORD DRAWING" PR-93-5

SHEET 22 OF 23 SHEETS

W/ OCB.22 P.K. (291193)